



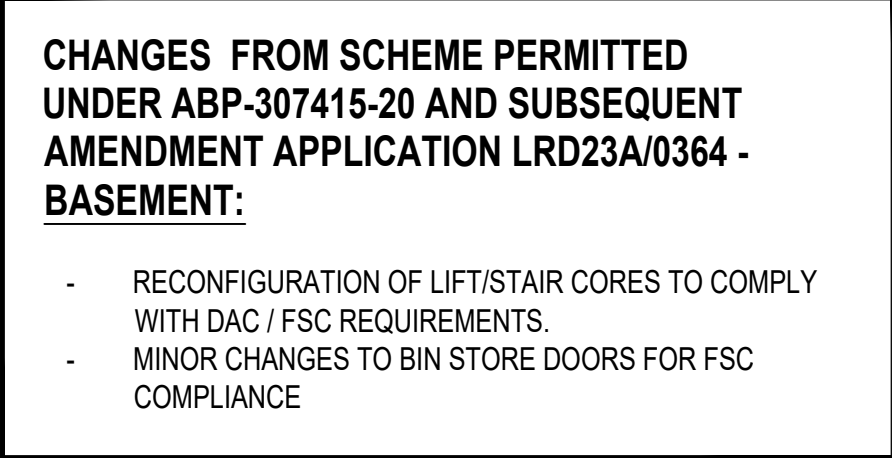

 GREEN COLOUR INDICATES
PARKING SPACE FOR EV
VEHICULAR CHARGING

LISIEUX PARK

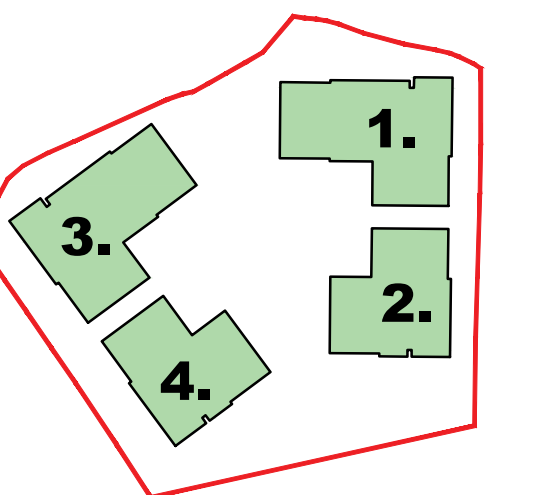

Notes:	Issue Status		No.	Date	Revision	Initials
1. Copyright Reserved	Progress		P02	06.10.2023	Planning Permission Application	MC
2. Work to figured dimensions only. Do not scale drawing.	Planning Application	■				
3. The contractor is responsible for checking all levels and dimensions on site and shall refer all discrepancies to the Architect	Fire Cert					
4. Where appropriate, for details of r.c. structure, or mechanical and electrical details, see Engineers drawings	Disability Cert					
5. Proprietary items shall be fixed in strict accordance with manufacturers instructions.	Tender					
6. Sizes of proprietary items shall be checked with manufacturer.	Construction					
7. The contractor shall be responsible for the coordination of structure, finishes and services.	As Built					
	Information Only					
M:\Project Section - Current\6275 Lisieux Hall\CAD\Planning\06 General Amendments Application\LIS-BKD-ZZ-B1-M2-A-1100_Basement Floor Plan.dwg 24/10/2023 14:08:10						

Project

RESIDENTIAL APARTMENTS, LISIEUX PARK

Murphystown Road, leopardstown, Dublin 18

6-7 HARDOULT TERRACE, DUBLIN 9, IRELAND

T: +353 (0)1 819 2410 F: +353 (0)1 819 2411

www.bkd.ie

6-7 HARDOULT TERRACE, DUBLIN 9, IRELAND

T: +353 (0)1 819 2410 F: +353 (0)1 819 2411

www.bkd.ie

www.bkd.ie

bkdarchitects

BURKE-KENNEDY DOYLE

Proposed Basement Floor Plan

Stage

Planning

Scale

1:200@A1

Drawn

SR

Apct

FF

Date

26.07.2022

Project Code

6275

job

LIS

origin

: BKD

zone

: 00

level

: B1

type

: DR

dis

: -A-

sheet no

: 1100

status

P3

rev

P02