

LEGEND:

- 1 BED STUDIO
- 1 BED APARTMENT
- 2 BED APARTMENT
- 3 BED APARTMENT

CHANGES FROM SCHEME PERMITTED UNDER ABP-307415-20 - FIRST FLOOR

THE FOLLOWING UNITS CONVERTED FROM STUDIOS TO 1 BED UNITS (WITH ADJACENT 1 BED UNITS REDUCED IN SIZE):

- BLOCK 1 - UNIT 29 (& 30)
- BLOCK 2 - UNIT 39 (& 40)
- BLOCK 3 - UNIT 44 (& 55)
- BLOCK 4 - UNIT 61 (& 62)

RECONFIGURATION OF LIFT/STAIR CORES TO COMPLY WITH DAC/FSC REQUIREMENTS.


EN-SUITES REMOVED FROM ALL 2 BED UNITS TO ALLOW SPACE FOR APARTMENT FRONT DOORS TO MOVE CLOSER TO THE PROTECTED CORE AND COMPLY WITH THE FSC.

CORRIDOR LENGTHS REDUCED AND DOORS MOVED CLOSER TO CORES TO ALL GABLE 2 BED UNITS TO SATISFY TRAVEL DISTANCES TO SUIT FSC.

ALL PERMITTED BEDROOM DOORS OPENING ON TO BALCONIES CHANGED TO WINDOWS TO IMPROVE SAFETY AND SECURITY.

**PROPOSED
FIRST FLOOR**

LISIEUX PARK

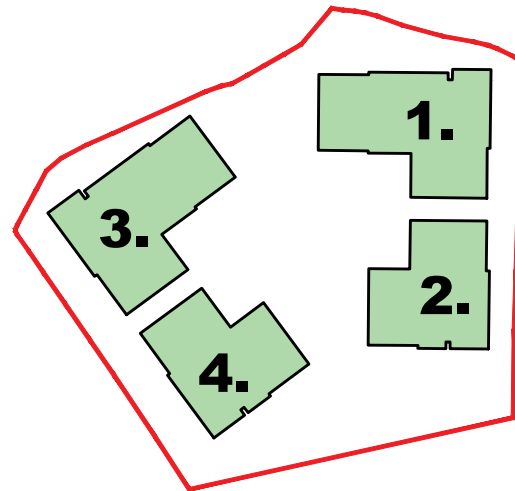

Notes		Issue Status		No.		Date		Revision		Initials	
1. Copyright Reserved		Progress		P03		06.10.2023		Planning Permission Application - General Amendments		MC	
2. Work to figured dimensions only. Do not scale drawing.		Planning Application									
3. The contractor is responsible for checking all levels and dimensions on site and shall refer all discrepancies to the Architect		Fire Cert									
4. Where appropriate, for details of r.c. structure, or mechanical and electrical details, see Engineers drawings		Disability Cert									
5. Proprietary items shall be fixed in strict accordance with manufacturers instructions.		Tender									
6. Sizes of proprietary items shall be checked with manufacturer.		Construction									
7. The contractor shall be responsible for the coordination of structure, finishes and services.		As Built									
		Information Only									
M:\Project Section - Current\6275 Lisieux Hall\CAD\Planning\06 General Amendments Application\US-BKD-ZZ-01-M2-A-1100_Floor Plan 01.dwg		19/10/2023 14:44:50									

Project		6-7 HARDCOURT TERRACE, DUBLIN 2, IRELAND	
Drawing Title		RESIDENTIAL APARTMENTS, LISIEUX PARK	
Stage		Murphystown Road, leopardstown, Dublin 18	
Scale		1:200@A1	
Job		LIS - BKD - 00 - 01 - DR - A - 1100	
Project Code		6275	
Status		P03	

bkdarchitects		BURKE-KENNEDY DOYLE	
www.bkd.ie			