

LEGEND:

- 1 BED STUDIO
- 1 BED APARTMENT
- 2 BED APARTMENT
- 3 BED APARTMENT
- CHANGE IN INTERNAL BUILDING FOOTPRINT FROM THAT APPROVED UNDER ABP-307415-20
- OUTLINE OF PERMITTED SCHEME

CHANGES FROM SCHEME PERMITTED UNDER ABP-307415-20 - FOURTH FLOOR

RECONFIGURATION OF LIFT/STAIR CORES TO COMPLY WITH DAC/FSC REQUIREMENTS.


EN-SUITES REMOVED FROM ALL 2 BED UNITS TO ALLOW SPACE FOR APARTMENT FRONT DOORS TO MOVE CLOSER TO THE PROTECTED CORES AND COMPLY WITH THE FSC.

CORRIDOR LENGTHS REDUCED AND DOORS MOVED CLOSER TO CORES TO ALL GABLE 2 BED UNITS TO SATISFY TRAVEL DISTANCES TO SUIT FSC.

ALL PERMITTED BEDROOM DOORS OPENING ON TO BALCONIES CHANGED TO WINDOWS TO IMPROVE SAFETY AND SECURITY.

**PROPOSED
FOURTH FLOOR**

LISIEUX PARK

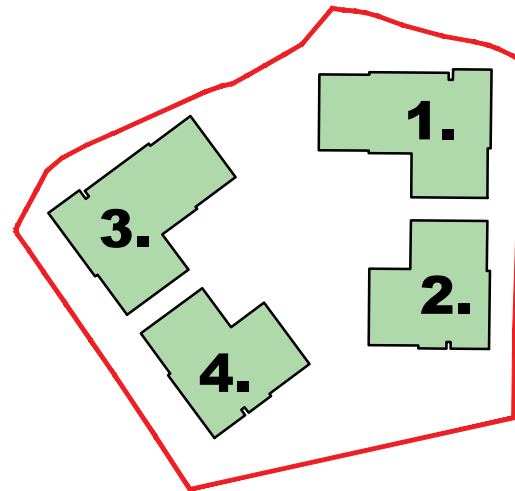

Notes 1. Copyright Reserved 2. Work to figured dimensions only. Do not scale drawing. 3. The contractor is responsible for checking all levels and dimensions on site and shall refer all discrepancies to the Architect. 4. Where appropriate, for details of r.c. structure, or mechanical and electrical details, see Engineers drawings. 5. Proprietary items shall be fixed in strict accordance with manufacturers instructions. 6. Sizes of proprietary items shall be checked with manufacturer. 7. The contractor shall be responsible for the coordination of structure, finishes and services.		Issue Status Progress Planning Application Fire Cert Disability Cert Tender Construction As Built Information Only		No. Date Revision P03 06.10.2023 Planning Permission Application - General Amendments		Initials MC
Project RESIDENTIAL APARTMENTS, LISIEUX PARK Murphystown Road, Leopardstown, Dublin 18		Drawing Title Proposed Fourth Floor Plan		Scale 1:200@A1		Date 03.04.2023
Stage Planning		Drawn SR		Appt FF		Rev P03
Project Code 6275		job LIS		zone BKD		status DR
				level 00		sheet no. 1100
				type DR		status A
						rev P03

6-7 HARDCURT TERRACE, DUBLIN 2, IRELAND
T: +353-1-618 2400 F: +353-1-678 7385
e: architecture@bkd.ie
www.bkd.ie

bkdarchitects
BURKE-KENNEDY DOYLE