

LEGEND:

- 1 BED STUDIO
- 1 BED APARTMENT
- 2 BED APARTMENT
- 3 BED APARTMENT
- CHANGE IN INTERNAL BUILDING FOOTPRINT FROM THAT APPROVED UNDER ABP-307415-20
- OUTLINE OF PERMITTED SCHEME
- GREEN ROOF

CHANGES FROM SCHEME PERMITTED UNDER ABP-307415-20 - FIFTH FLOOR

RECONFIGURATION OF LIFT/STAIR CORES TO COMPLY WITH DAC/FSC REQUIREMENTS.

EN-SUITES REMOVED FROM ALL 2 BED UNITS TO ALLOW SPACE FOR APARTMENT FRONT DOORS TO MOVE CLOSER TO THE PROTECTED CORES AND COMPLY WITH THE FSC.

CORRIDOR LENGTHS REDUCED AND DOORS MOVED CLOSER TO CORES TO ALL GABLE 2 BED UNITS TO SATISFY TRAVEL DISTANCES TO SUIT FSC.


ALL PERMITTED BEDROOM DOORS OPENING ON TO BALCONIES CHANGED TO WINDOWS TO IMPROVED SAFETY AND SECURITY.

BLOCK 2 & 4 ROOFS: 4 ADDITIONAL SMOKE CONTROL AOV'S AND LIFT OVERRUNS ADDED TO COMPLY WITH REQUIREMENTS OF FSC.

48 LOW-PITCH PV PANELS ADDED FOR COMPLIANCE WITH BUILDING REGS PART L

GLAZED ATRIUM REMOVED ABOVE STAIR AND LIFT CORE

LISIEUX PARK

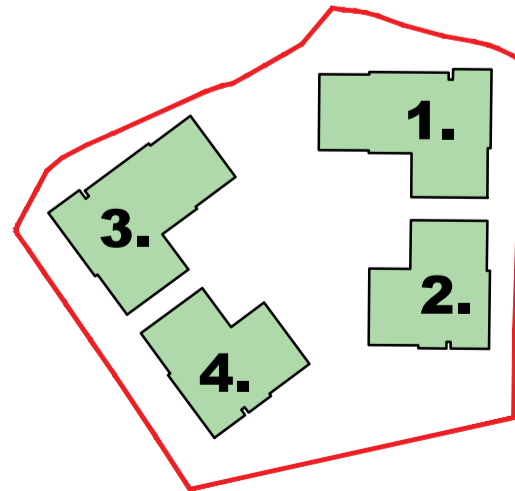

PROPOSED FIFTH FLOOR

Notes		Issue Status		No.		Date		Revision		Initials	
1. Copyright Reserved		Progress		P03		06.10.2023		Planning Permission Application – General Amendments		MG	
2. Work to figured dimensions only. Do not scale drawing.		Planning Application									
3. The contractor is responsible for checking all levels and dimensions on site and shall refer all discrepancies to the Architect		Fire Cert									
4. Where appropriate, for details of r.c. structure, or mechanical and electrical details, see Engineers drawings		Disability Cert									
5. Proprietary items shall be fixed in strict accordance with manufacturers instructions.		Tender									
6. Sizes of proprietary items shall be checked with manufacturer.		Construction									
7. The contractor shall be responsible for the coordination of structure, finishes and services.		As Built									
		Information Only									
M:\Project Section - Current\6275 Lisieux Hall\CAD\Planning\06 General Amendments Application\LIS-BKD-ZZ-05-M2-A-1100_Floor Plan 05.dwg		19/10/2023 15:14:00									

Project		RESIDENTIAL APARTMENTS, LISIEUX PARK		6-7 HARDCURT TERRACE, DUBLIN 2, IRELAND	
Drawing Title		Proposed Fifth Floor Plan		1+363-1-618 2100 1+363-1-678 7385	
Stage		Planning		www.bkd.ie	
Project Code		6275		bkdarchitects	
Job		LIS		BURKE-KENNEDY DOYLE	
Origin		BKD			
Zone		00			
Level		05			
Type		DR			
Dis		A			
Sheet no.		1100			
Status		P03			
Rev					