

CHANGES FROM SCHEME PERMITTED
UNDER ABP-307415-20 - ROOF LEVEL


BLOCK 1 ROOF: 2 ADDITIONAL SMOKE
CONTROL AOV'S AND 1 LIFT OVERRUN
ADDED TO COMPLY WITH REQUIREMENTS OF
FSC.

36 LOW-PITCH PV PANELS ADDED FOR
COMPLIANCE WITH BUILDING REGS PART L

GLAZED ATRIUM REMOVED ABOVE STAIR
AND LIFT CORE

GREEN ROOF

LISIEUX PARK

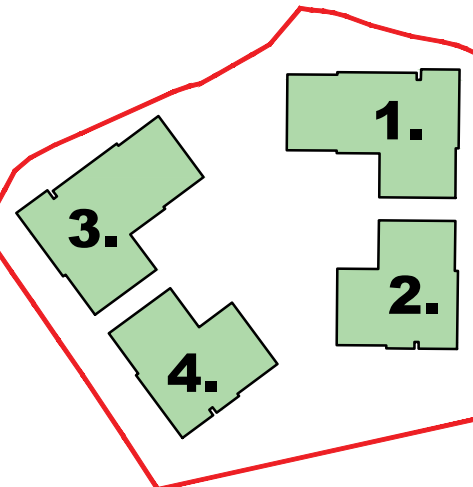

PROPOSED
ROOF PLAN

Notes		Issue Status		No.		Date		Revision		Initials	
1. Copyright Reserved		Progress		P03		06.10.2023		Planning Permission Application - General Amendments		MG	
2. Work to figure dimensions only. Do not scale drawing.		Planning Application									
3. The contractor is responsible for checking all levels and dimensions on site and shall refer all discrepancies to the Architect.		Fire Cert									
4. Where appropriate, for details of r.c. structure, or mechanical and electrical details, see Engineers drawings.		Disability Cert									
5. Proprietary items shall be fixed in strict accordance with manufacturers instructions.		Tender									
6. Sizes of proprietary items shall be checked with manufacturer.		Construction									
7. The contractor shall be responsible for the coordination of structure, finishes and services.		As Built									
M:\Project Section - Current\6275 Lisieux Hall\CAD\Planning\06 General Amendments Application\LIS-BKD-ZZ-RF-M2-A-1100_Roof Plan.dwg		Information Only									
19/10/2023 15:23:45											

Project		RESIDENTIAL APARTMENTS, LISIEUX PARK		6-7 HARDCOURT TERRACE, DUBLIN 2, IRELAND	
Drawing Title		Murphystown Road, leopoldstown, Dublin 18		1 + 360-1-618 2100 1 + 360-1-678 1385	
Stage		Planning		www.bkd.ie	
Scale		1:200@A1		bkdarchitects	
Project Code		6275		BURKE-KENNEDY DOYLE	
Job		LIS - BKD - 00 - RF - DR - A -			
Zone		1100			
Level		P03			
Type					
Dis					
Sheet no.					
Status					
Rev					
Date		23.05.2022			