



LEGEND	
FINISHES AS PERMITTED	
	(5) BLANCO SERENA GRANITE (Granite Honed Finish) At ground to first floor level and ground floor colonnade
	(6) CREAM FATIMA LIMESTONE (Limestone Honed Finish) At bays to upper levels, above first floor
	(7) KARELIA RED GRANITE (Granite Honed Finish) At bays to upper levels
	(8) THROUGH COLOUR RENDER FINISH GREY OR SIMILAR APPROVED To Penthouse Levels
	(9) THROUGH COLOUR RENDER FINISH BEIGE OR SIMILAR APPROVED Internal Courtyard - Upper floor levels
	(10) THROUGH COLOUR RENDER FINISH RED OR SIMILAR APPROVED Internal Courtyard - Upper floor levels
NOTE: COLOURS ARE INDICATIVE ONLY.	


CHANGES FROM SCHEME PERMITTED UNDER ABP-307415-20:

- (1) ALL PERMITTED BEDROOM DOORS
OPENING ON TO BALCONIES CHANGED
TO WINDOWS TO IMPROVE SAFETY
AND SECURITY.
- (2) PERMITTED GLAZED ATRIUM AT ROOF
LEVEL (ABOVE STAIR AND LIFT CORE)
REMOVED FOR FSC PURPOSES
- (3) GLAZED LINK CORRIDORS BETWEEN
BUILDINGS REMOVED
- (4) FENESTRATION SHOWN IN ELEVATION
TO TALLY WITH PERMITTED PLANS
- (5) MINOR CHANGES TO FENESTRATION
TO ACCOMMODATE IMPROVED
APARTMENT FLOOR PLANS
- (6) WINDOWS TO WC SHOWER AREA
OMITTED FOR PRIVACY
- (7) MODIFICATIONS TO FACADE TO
ACCOMMODATE REQUIRED VEHICLE
HEIGHT AT ENTRANCE TO BASEMENT
CAR PARK, FOR PART M & DAC
COMPLIANCE PURPOSES
- (8) REVISED ENTRANCE TO CRECHE
- (9) NON-STRUCTURAL COLUMNS OMITTED
FROM BALCONIES TO IMPROVE
DAYLIGHT INTO APARTMENTS

NOTE: TREES SHOWN AS INDICATIVE ONLY,
REFER TO THE ARBORISTS REPORTS, TREE
PROTECTION PLANS AND LANDSCAPE
MASTERPLAN FOR DETAILS ON ALL TREES



LISIEUX PARK

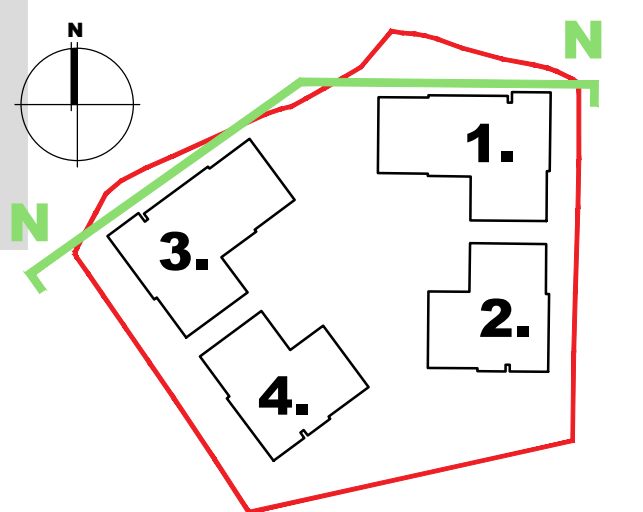

North Elevations Permitted & Proposed

Notes		Issue Status		No.		Date		Revision		Initials	
1. Copyright Reserved		Progress		P01		06.10.2023		SR		MC	
2. Work to figure dimensions only. Do not scale drawing.		Planning Application									
3. The contractor is responsible for checking all levels and dimensions on site and shall refer all discrepancies to the Architect.		Fire Cert									
4. Where appropriate, for details of r.c. structure, or mechanical and electrical details, see Engineers drawings		Disability Cert									
5. Proprietary items shall be fixed in strict accordance with manufacturers instructions.		Tender									
6. Sizes of proprietary items shall be checked with manufacturer.		Construction									
7. The contractor shall be responsible for the coordination of structure, finishes and services.		As Built									
M:\Project Section - Current\6275 Lisieux Hall\CAD\Planning\06 General Amendments Application\Permitted Vs Proposed North And East Balcony Amendments.dwg, 15/11/2023		Information Only									

Project		6-7 HARDCOURT TERRACE, DUBLIN 2, IRELAND	
RESIDENTIAL APARTMENTS, LISIEUX PARK		1 + 363-1-618 2100 1 + 363-1-676 7385	
Murphystown Road, Leopardstown, Dublin 18		www.bkd.ie	
Drawing Title		North Elevations - Permitted and Proposed	
Stage	Scale	Drawn	Date
Planning	1:200@A1	SR	23.05.2022
Project Code	job	origin	zone
6275	LIS	BKD	ZZ
level	type	dis	sheet no.
	DR	A	2000
status	rev		
P01			

bkdarchitects
BURKE-KENNEDY DOYLE