



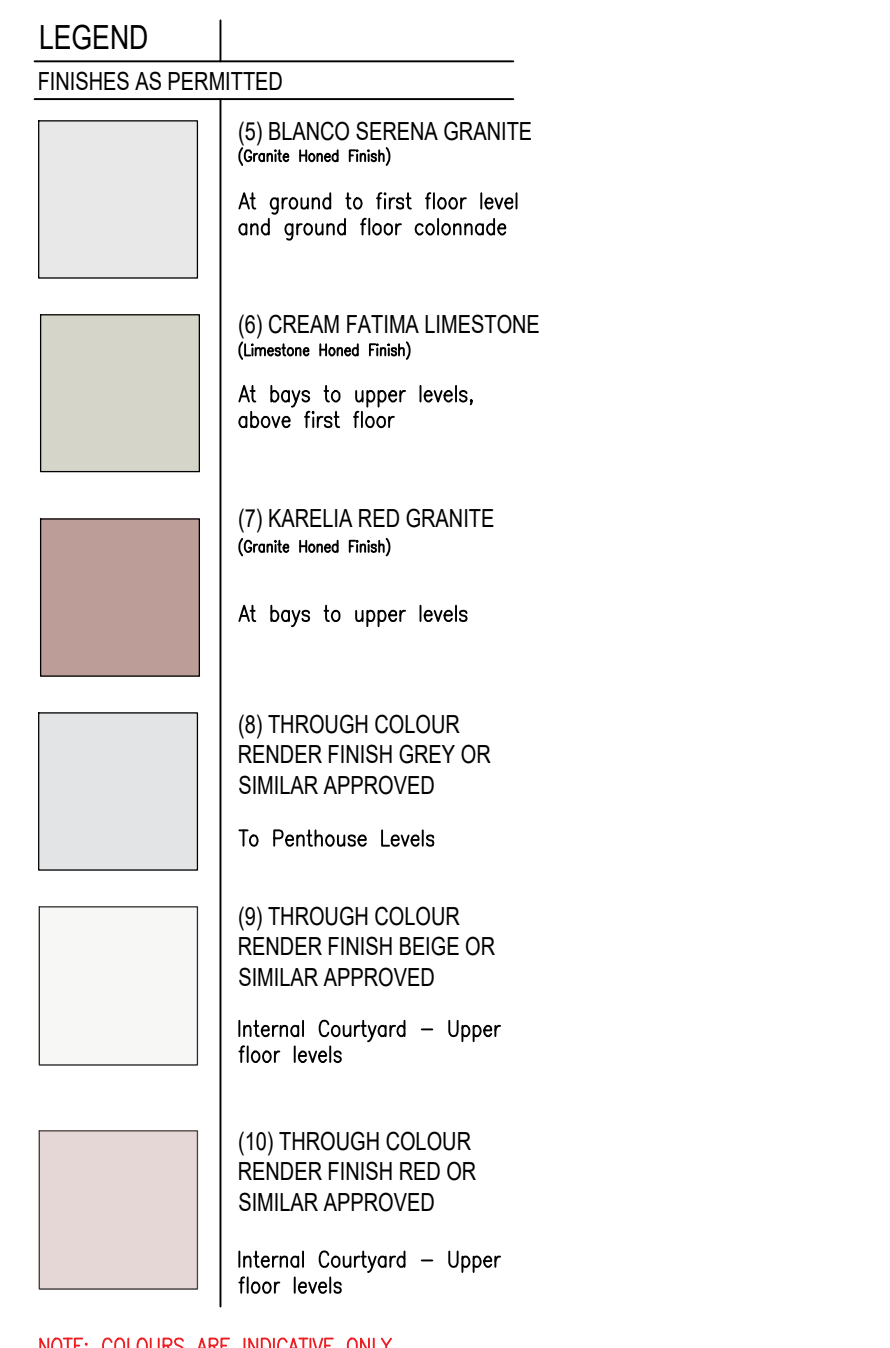

**CHANGES FROM SCHEME PERMITTED UNDER
ABP-307415-20:**

- (1) ALL PERMITTED BEDROOM DOORS
OPENING ON TO BALCONIES CHANGING
TO WINDOWS TO IMPROVE SAFETY
AND SECURITY.
- (2) PERMITTED GLAZED ATRIUM AT ROOF
LEVEL (ABOVE STAIR AND LIFT CORE)
REMOVED FOR FSC PURPOSES
- (3) GLAZED LINK CORRIDORS BETWEEN
BUILDINGS REMOVED
- (4) FENESTRATION SHOWN IN ELEVATION
TO TALLY WITH PERMITTED PLANS
- (5) NON-STRUCTURAL COLUMNS OMITTED
FROM BALCONIES TO IMPROVE
DAYLIGHT INTO APARTMENTS

NOTE: TREES SHOWN AS INDICATIVE ONLY,
REFER TO THE ARBORISTS REPORTS, TREE
PROTECTION PLANS AND LANDSCAPE
MASTERPLAN FOR DETAILS ON ALL TREES

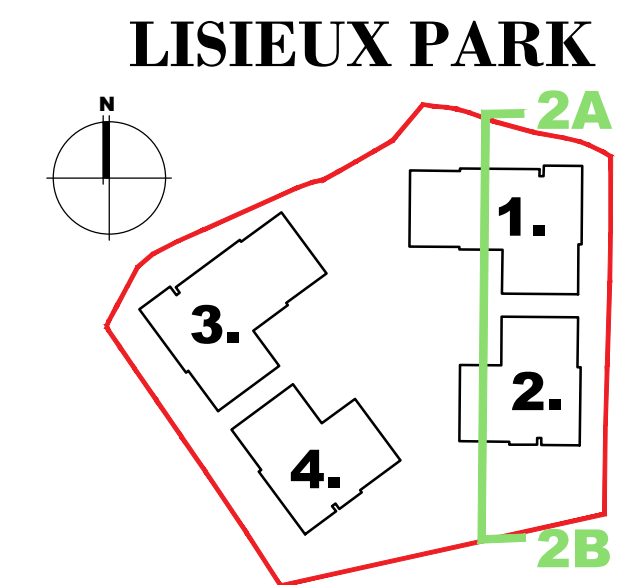

Notes		Issue Status		No.		Date		Revision		Initials	
1. Copyright Reserved		Progress		P01		06.10.2023		Planning		MG	
2. Work to figured dimensions only. Do not scale drawing.		Planning Application									
3. The contractor is responsible for checking all levels and dimensions on site and shall refer all discrepancies to the Architect		Fire Cert									
4. Where appropriate, for details of r.c. structure, or mechanical and electrical details, see Engineers drawings		Disability Cert									
5. Proprietary items shall be fixed in strict accordance with manufacturers instructions.		Tender									
6. Sizes of proprietary items shall be checked with manufacturer.		Construction									
7. The contractor shall be responsible for the coordination of structure, finishes and services.		As Built									
		Information Only									
M:\Project Section - Current\6275 Lisieux Hall\CAD\Planning\06) General Amendments Application\Permitted Vs Proposed Podium, Balcony Amendments.dwg		15/11/2023 15:27:01									

Project		RESIDENTIAL APARTMENTS, LISIEUX PARK				6-7 HANDOUT TERRACE, DUBLIN 2, IRELAND															
		Murphystown Road, Leopardstown, Dublin 18				T: +353 1 618 2940 F: +353 1 618 2941															
						e: arch@bkd.ie															
						www.bkd.ie															
Drawing Title		Contextual Section 2A-2B - Permitted and Proposed																			
Stage		Planning		Scale		1:200@A1		Drawn		SR		App'd		FF		Date		23.05.2022			
Project Code		6275		LIS		- BKD		- ZZ		- ZZ		- DR		- A-		2005		status		rev	
																		P01			

